

9

2019R-027125
RECORDED ON
10/07/2019 12:45:21 PM
BRANDON DENBY
REGISTER OF DEEDS
LIVINGSTON COUNTY, MI 48843
RECORDING: 26.00
REMON: 4.00
PAGES: 9



**FOURTH AMENDMENT TO THE MASTER DEED
OF "GEORGETOWN SITE CONDOMINIUM" PLAN NO 262**

High Country Estates, Inc., a Michigan Corporation, hereinafter referred to as "Developer", whose address is PO Box 400, Brighton, Michigan 48116 has established "Georgetown Site Condominium", a condominium project pursuant to the Master Deed thereof as recorded on October 23, 2002 in Liber 3576 pages 0555 through 0616, Livingston County Records and designated as Livingston County Condominium Subdivision Plan No. 262 does hereby execute and declare this Fourth Amendment to the Master Deed of "Georgetown Site Condominium" pursuant to the authority reserved to the Developer in Article VII of the Master Deed for the purpose of a correction of Exhibit "B", and revision of Article V sections 1 & 2. The Master Deed has previously been Amended, First Amendment recorded 5-18-2004 in Liber 4450, pages 40 through 48, Second Amendment recorded 1-14-2010 as Document No. 2010 R-001264, Third Amendment recorded 8-16-2012 as Document No. 2012R-028059, Livingston County Records, as plan No. 262.

FOURTH AMENDED EXHIBIT "B"

Sheets 1, 2, 3, 4, 5, 6 and 7 of Exhibit "B" to this Fourth Amendment to the Master Deed of "Georgetown Site Condominium" shall replace and supersede Sheets 1, 2, 3, 4, 5, 6 and 7 of Exhibit "B" to the Master Deed and that original sheets referred to as attached to the Master Deed shall thereupon be of no further force or effect.

AMENDED ARTICLE "V"

Section 1. Description Of Units. Each Unit in the Condominium Project is described in the Condominium Subdivision Plan of the Fourth Amendment to the Master Deed of GEORGETOWN SITE CONDOMINIUM which is attached hereto as Exhibit "B". There are now sixteen (16) Units created for residential use in the Condominium Project established by this Master Deed. Each Unit shall consist of the space (land area) located within horizontal and vertical Unit boundaries as delineated on Exhibit "B" hereto together with all appurtenances thereto.

Section 2. Percentage Of Value. The total value of the Project is 100%. The determination of the percentages of value was made after reviewing the comparative characteristics of each Unit in the Project which would affect maintenances costs and concluding that there are no material differences. The percentage of value assigned to each Unit shall be determinative of each Co-Owner's respective share of the General Common Elements of the Condominium Project, the proportionate share of each respective Co-Owner in the proceeds and the expenses of administration and the value of such Co-Owner's vote at meetings of the Association of Co-Owners. Accordingly, the percentage of value assigned to each of the sixteen (16) single family residential Units shall be equal.

Sections 3 and 4 of Article V remain unchanged.

10-07-19P12:41 RCVD

RATIFICATION OF MASTER DEED

In all other respects, other than as hereinabove indicated, the Master Deed of "Georgetown Site Condominium", specifically including Condominium Bylaws, Exhibit "A" thereto, and the Condominium Subdivision Plan, Exhibit "B" thereto, are hereby ratified, confirmed and redeclared.

This Fourth Amendment to the Master Deed of "Georgetown Site Condominium" is hereby executed this _____ day of November, 2013.


DEVELOPER: HIGH COUNTRY ESTATES Inc., A Michigan Corporation


By Charles P delGaudio , President

STATE OF MICHIGAN }
 }ss
COUNTY OF LIVINGSTON}

The foregoing instrument was acknowledged before me this 7th day of October 2019, by Charles P. delGaudio, President of High Country Estates Inc., a Michigan Corporation, on behalf of the corporation.

Gabriella L. Garlock
Notary Public
Livingston County, Michigan
Comm Expires 8-30-26
Acting in _____ County, Michigan




Notary Public Livingston County
My commission expires _____

↓
**PREPARED BY & RETURN TO: Russell Springborn 3535 High Hillcrest Drive, Howell MI 48843-~~6~~
~~HIGH COUNTRY ESTATES PO BOX 400, BRIGHTON, MI 48116-0400~~**

EAST-WEST 1/4 LINE SECTION 4

R. 89°24'45" E. 2834.17'

E 1/4 COR. SECTION 4 T28N-04E

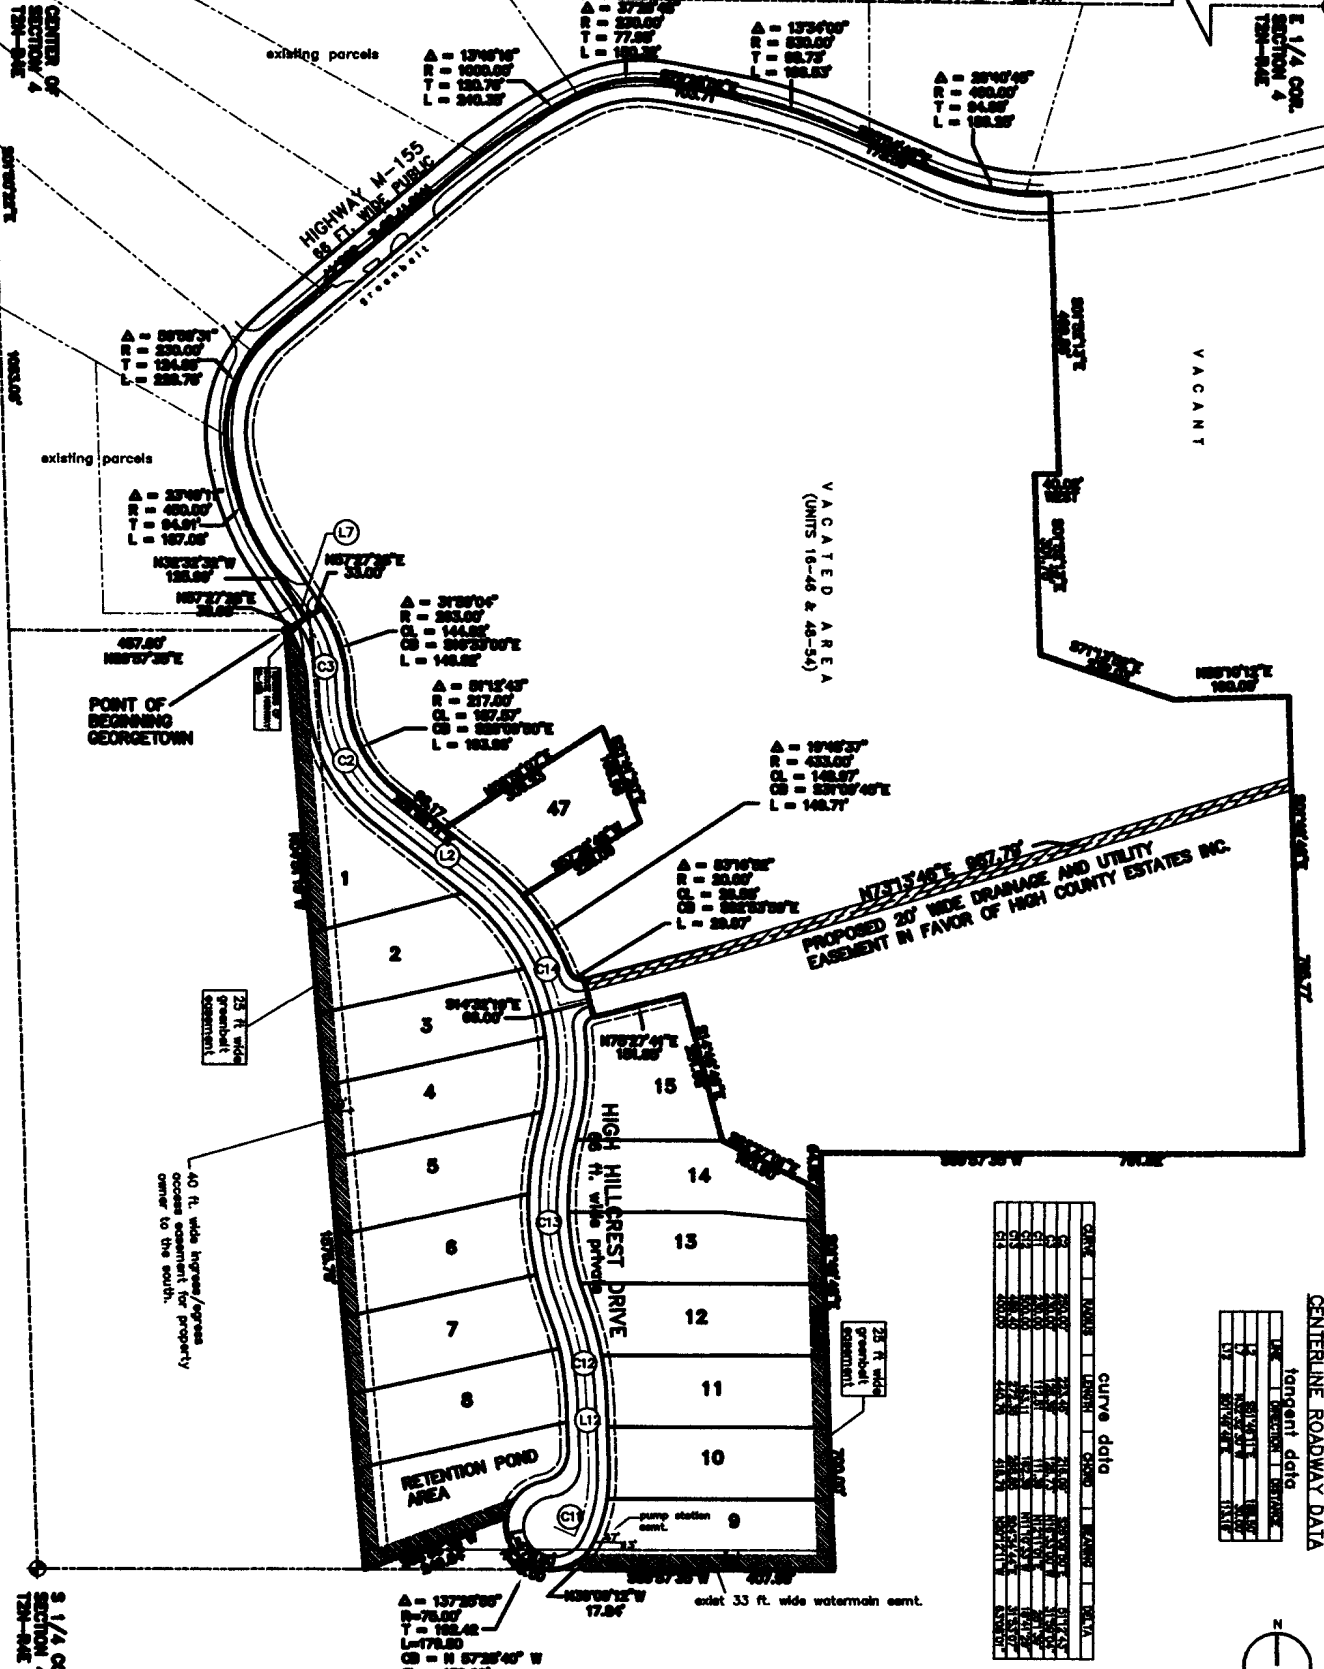

curve data

CHORD	ARC	CHORD BEARING	CHORD LENGTH	ARC BEARING	ARC LENGTH
1	2	100°00'00"	100.00'	100°00'00"	100.00'
2	3	100°00'00"	100.00'	100°00'00"	100.00'
3	4	100°00'00"	100.00'	100°00'00"	100.00'
4	5	100°00'00"	100.00'	100°00'00"	100.00'
5	6	100°00'00"	100.00'	100°00'00"	100.00'
6	7	100°00'00"	100.00'	100°00'00"	100.00'
7	8	100°00'00"	100.00'	100°00'00"	100.00'
8	9	100°00'00"	100.00'	100°00'00"	100.00'
9	10	100°00'00"	100.00'	100°00'00"	100.00'
10	11	100°00'00"	100.00'	100°00'00"	100.00'
11	12	100°00'00"	100.00'	100°00'00"	100.00'
12	13	100°00'00"	100.00'	100°00'00"	100.00'
13	14	100°00'00"	100.00'	100°00'00"	100.00'
14	15	100°00'00"	100.00'	100°00'00"	100.00'

centerline roadway data



CHORD	ARC	CHORD BEARING	CHORD LENGTH	ARC BEARING	ARC LENGTH
1	2	100°00'00"	100.00'	100°00'00"	100.00'
2	3	100°00'00"	100.00'	100°00'00"	100.00'
3	4	100°00'00"	100.00'	100°00'00"	100.00'
4	5	100°00'00"	100.00'	100°00'00"	100.00'
5	6	100°00'00"	100.00'	100°00'00"	100.00'
6	7	100°00'00"	100.00'	100°00'00"	100.00'
7	8	100°00'00"	100.00'	100°00'00"	100.00'
8	9	100°00'00"	100.00'	100°00'00"	100.00'
9	10	100°00'00"	100.00'	100°00'00"	100.00'
10	11	100°00'00"	100.00'	100°00'00"	100.00'
11	12	100°00'00"	100.00'	100°00'00"	100.00'
12	13	100°00'00"	100.00'	100°00'00"	100.00'
13	14	100°00'00"	100.00'	100°00'00"	100.00'
14	15	100°00'00"	100.00'	100°00'00"	100.00'

ASBUILT DATED 05-13-15

S 1/4 CORNER SECTION 4 T28N-04E



<p>2</p>	<p>ACE CIVIL ENGINEERS, LLC</p>	<p>GEORGETOWN A SITE CONDOMINIUM COMPOSITE PLAN</p>	<p>DEVELOPER HIGH COUNTY ESTATES P.O. BOX 400 BRIGHTON, N.C. 28116 810-599-5179</p>	<p>REVISIONS</p> <table border="1"> <tr><td> </td><td> </td><td> </td><td> </td></tr> <tr><td> </td><td> </td><td> </td><td> </td></tr> <tr><td> </td><td> </td><td> </td><td> </td></tr> <tr><td> </td><td> </td><td> </td><td> </td></tr> </table>																
<p>PROJECT NO. 05-13-15</p> <p>DRAWN BY: []</p> <p>CHECKED BY: []</p> <p>DATE: 05-13-15</p>	<p>SCALE: AS SHOWN</p>	<p>DATE: 05-13-15</p>	<p>BY: []</p>																	

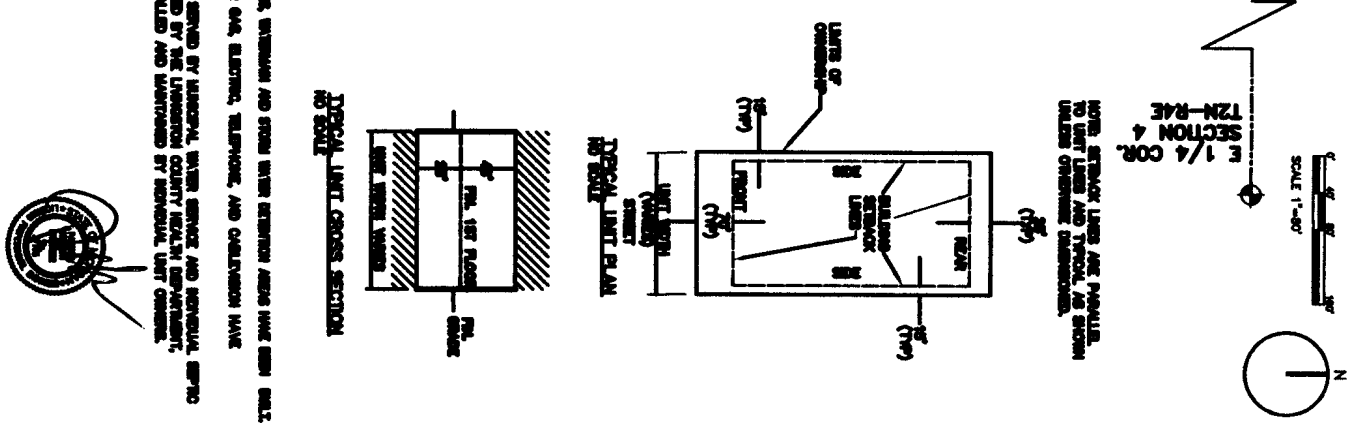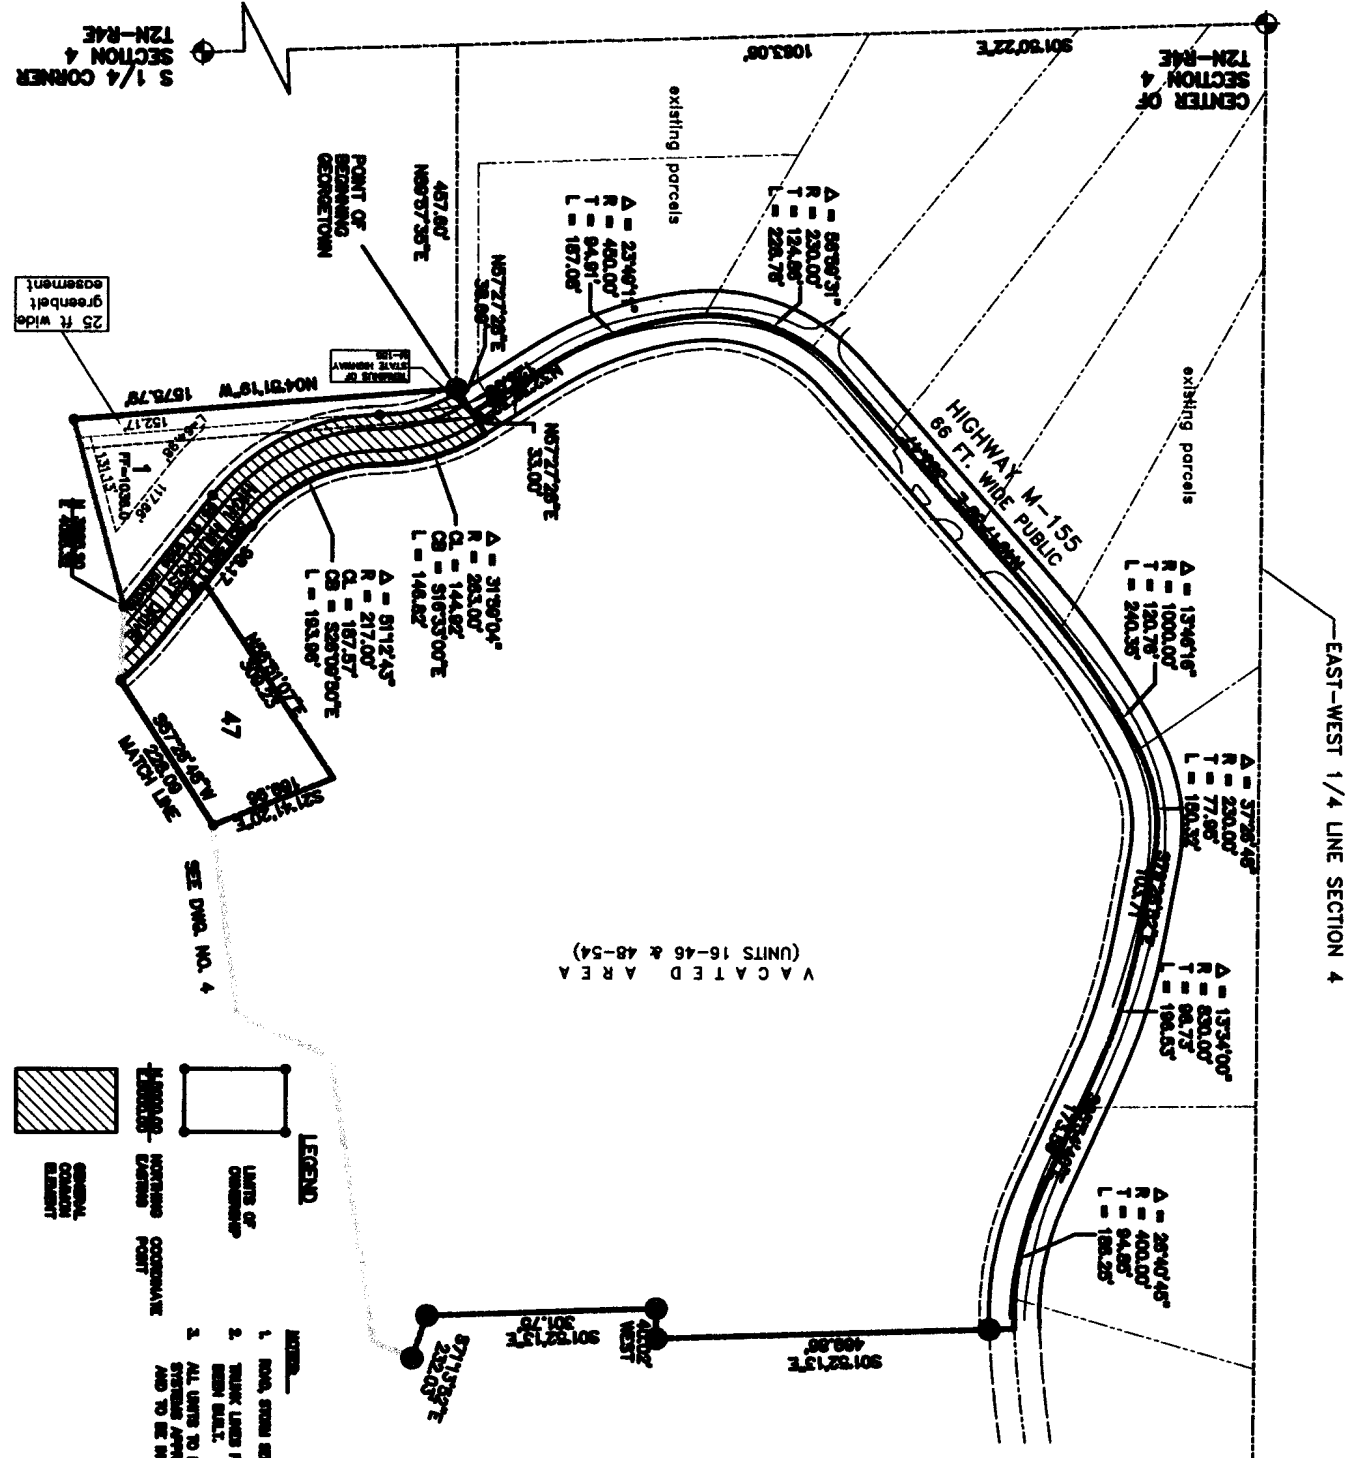

NOTES:

1. ROAD, STORM SEWER, WATERMAIN AND STORM WATER RETENTION BASIN HAVE BEEN BUILT.
2. TRUNK LINES FOR GAS, ELECTRIC, TELEPHONE, AND CABLEVISION HAVE BEEN BUILT.
3. ALL UTILITIES TO BE SERVED BY MUNICIPAL, WATER SERVICE AND MUNICIPAL SEWER SYSTEMS APPROVED BY THE LIVINGSTON COUNTY HEALTH DEPARTMENT, AND TO BE INSTALLED AND MAINTAINED BY INDIVIDUAL UNIT OWNERS.

ASBUILT DATED 05-13-13

ACE CIVIL

GEORGETOWN
A SITE CONDOMINIUM
SITE PLAN

DEVELOPER
HIGH COUNTRY ESTATES
8475 BISHOP ROAD
BRIGHTON, M. 48116
(810) 231-0855

REVISIONS

NO.	DATE	DESCRIPTION

